



REV	AS-BUILT DRAWING	DATE
0	AS-BUILT DRAWING	06.02.15

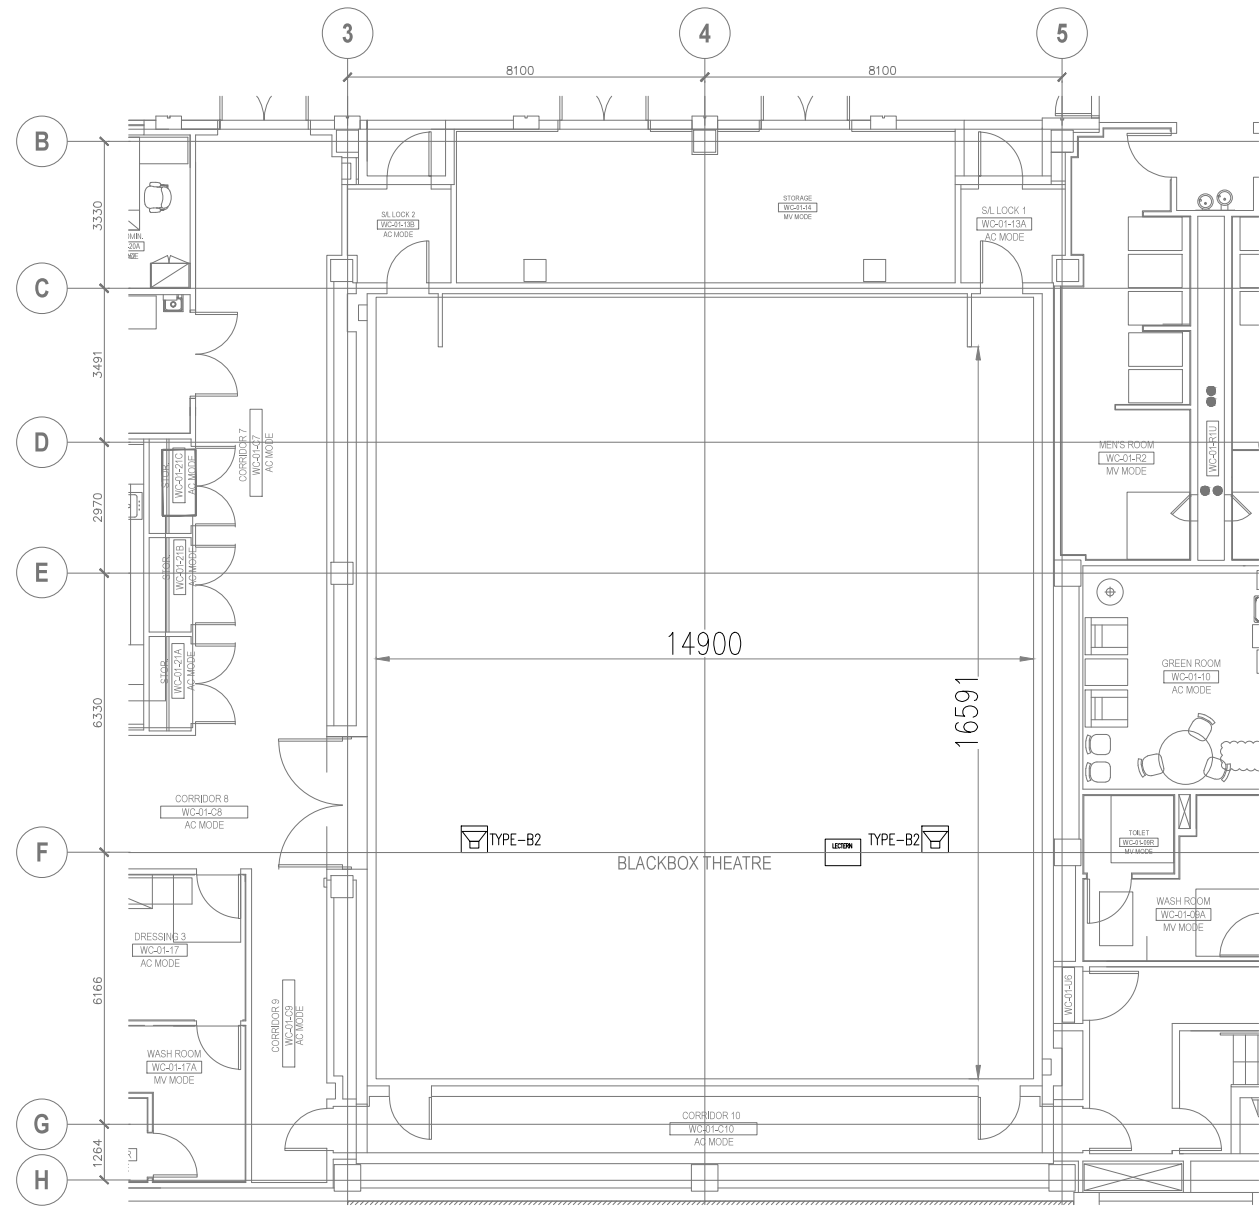

- PROJECT ARCHITECT**
 FORUM ARCHITECTS PTE LTD
 47 ANN SENG RD #06-01
 SINGAPORE 069720
- DESIGN CONSULTANT:**
 PELLI CLARKE PELLI
 1056 CHAPEL STREET,
 NEW HAVEN CT 06510
- CIVIL & STRUCTURAL ENGINEER:**
 MEINHARDT (SINGAPORE) PTE LTD
 108 JALAN BUKIT MERAH
 #09-01 SUREBANA ONE,
 SINGAPORE 150168
- MECHANICAL & ELECTRICAL ENGINEER:**
 MEINHARDT (SINGAPORE) PTE LTD
 108 JALAN BUKIT MERAH
 #09-01 SUREBANA ONE,
 SINGAPORE 150168
- QUANTITY SURVEYOR:**
 RIDER LEVETT BUCKNALL LPP
 150 BEACH ROAD
 #09-01 GATEWAY WEST,
 SINGAPORE 189720
- LANDSCAPE ARCHITECT:**
 LEKKER DESIGN PTE LTD
 82 TIONG POH ROAD #01-25
 SINGAPORE 160082
- LIGHTING CONSULTANT:**
 LIGHTING PLANNERS ASSOCIATES
 51B NEL ROAD,
 SINGAPORE 088829
- FOOD SERVICE CONSULTANT:**
 ROMANO GATLAND ASIA PACIFIC
 101 RAMA 9,
 SOI 60 SHANLIANG,
 BANGKOK 10200 THAILAND
- AV/ACOUSTIC /V /ESD/RECORDING/FACADE/THEATRE CONSULTANT:**
 ARUP SINGAPORE PTE LTD
 10 HOE CHIANG ROAD,
 #26-01 KEPPEL TOWERS,
 SINGAPORE 098315
- SIGNAGE CONSULTANT:**
 SQUARE PEG DESIGN ASIA PTE LTD
 212B TELOK AYER STREET,
 SINGAPORE 088645
- LAB CONSULTANT:**
 SKM SINGAPORE PTE LTD
 80 MARINE PARADE ROAD
 #18-10/04 PARKWAY PARADE,
 SINGAPORE 449269

PROJECT TITLE
 PROPOSED ERECTION OF YALE-NUS COLLEGE CAMPUS
 COMPRISING OF RESIDENTIAL COLLEGES 1,2,3,
 1 BLOCK OF 4-STORY PERFORMANCE ARTS BUILDING,
 1 BLOCK OF 4-STORY SPORTS HALL/ LIBRARY/
 ADMINISTRATION AND SCIENCE TEACHING BUILDING
 MK 03 ON LOT 04564P, DOVER ROAD

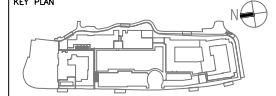

01 1ST STOREY BLACK BOX THEATRE EQUIPMENT PLAN LAYOUT

AS-BUILT DRAWING

DRAWING TITLE
 WEST CORE - BLACK BOX
 EQUIPMENT LAYOUT
 1st STOREY PLAN

SCALE	1:50	DRAWN BY	B.R.
DATE	12.11.13	CHECKED BY	K.C. LUN
DIVISION	16800	DRAWING NO.	A-AB-WC-BB1-840-SP-09

MAIN CONTRACTOR

 SSANGYONG
 ENGINEERING & CONSTRUCTION CO. LTD

SUB-CONTRACTOR

 DESINI ASIA PTE LTD
 1 UBI MIDWAY
 FOCUS ONE, SINGAPORE 408555
 TEL: 65 4941 1811
 TEL: 65 6844 3533
 www.desini.tv